
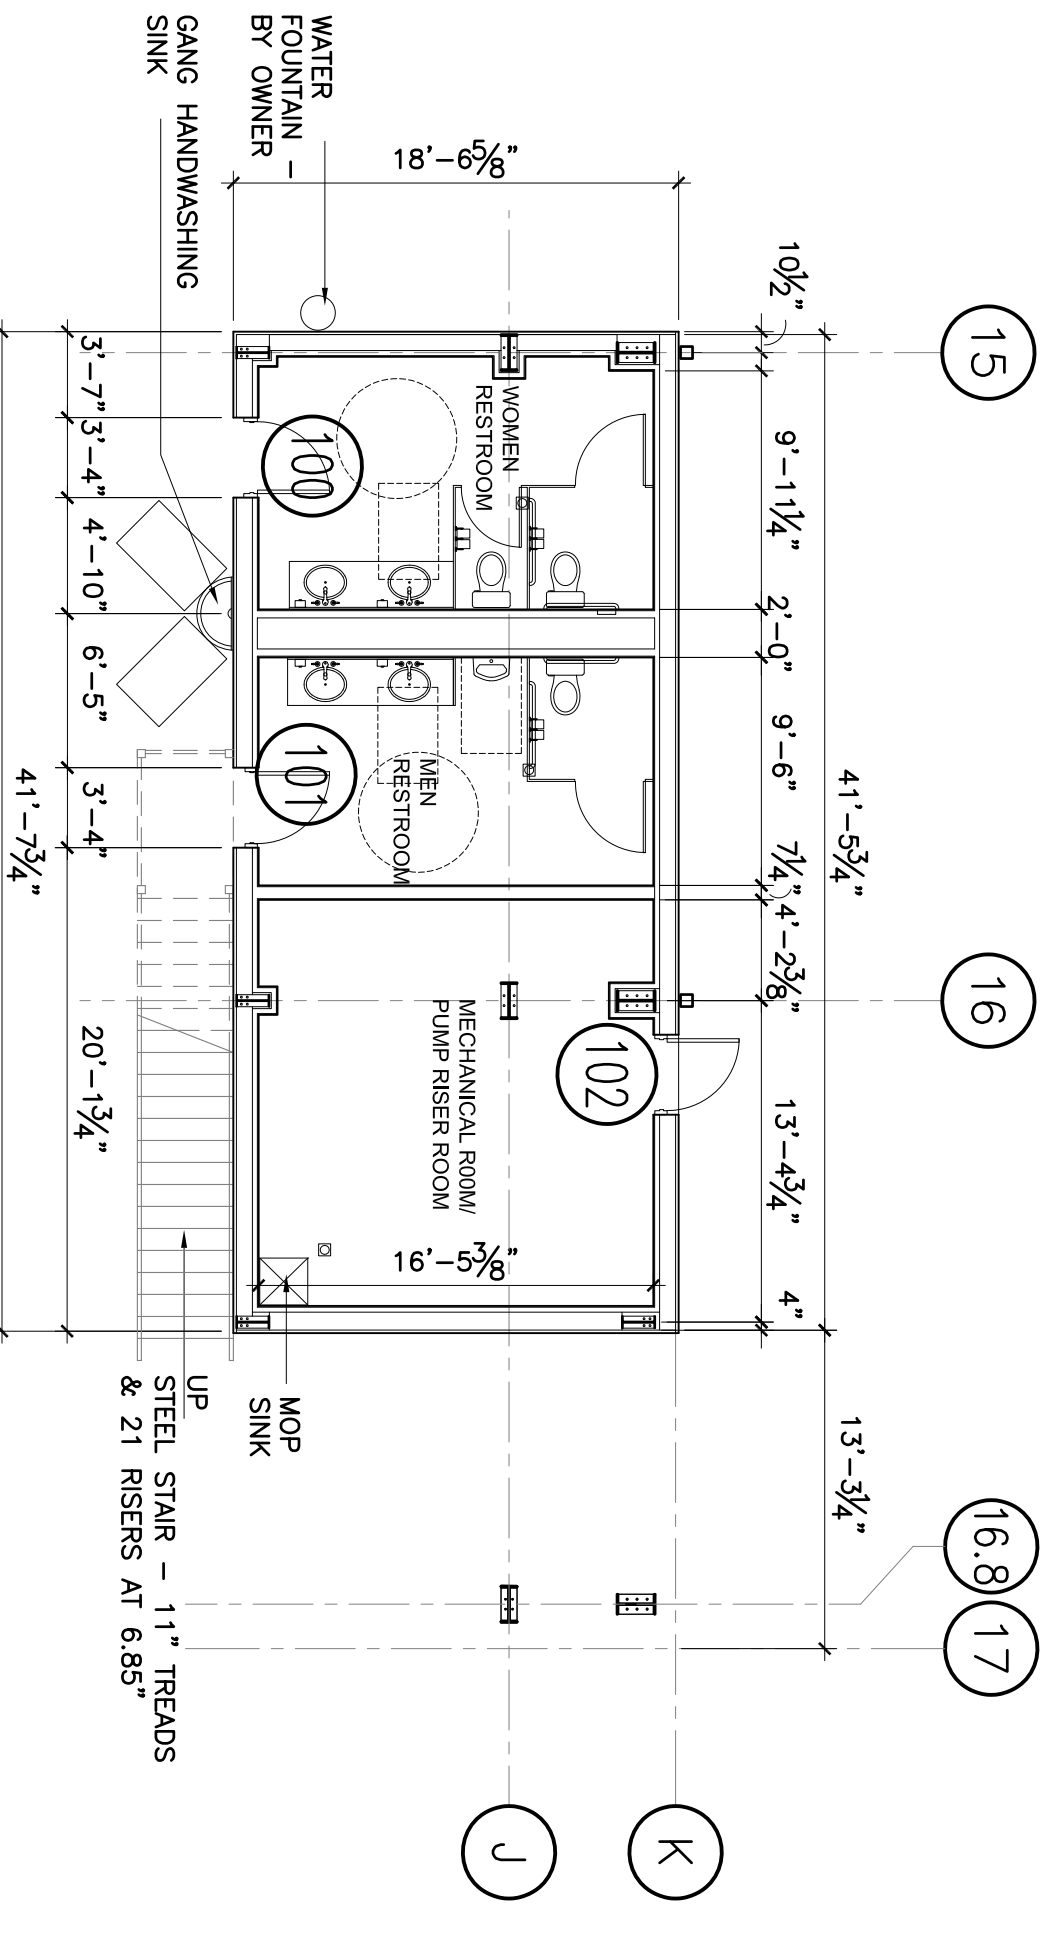



1 FIRST FLOOR PLAN

A1.0 SCALE: 1/16" = 1'-0"

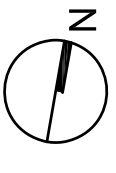


2 FIRST FLOOR PLAN - RESTROOMS

A1.0 SCALE: 1/8" = 1'-0"

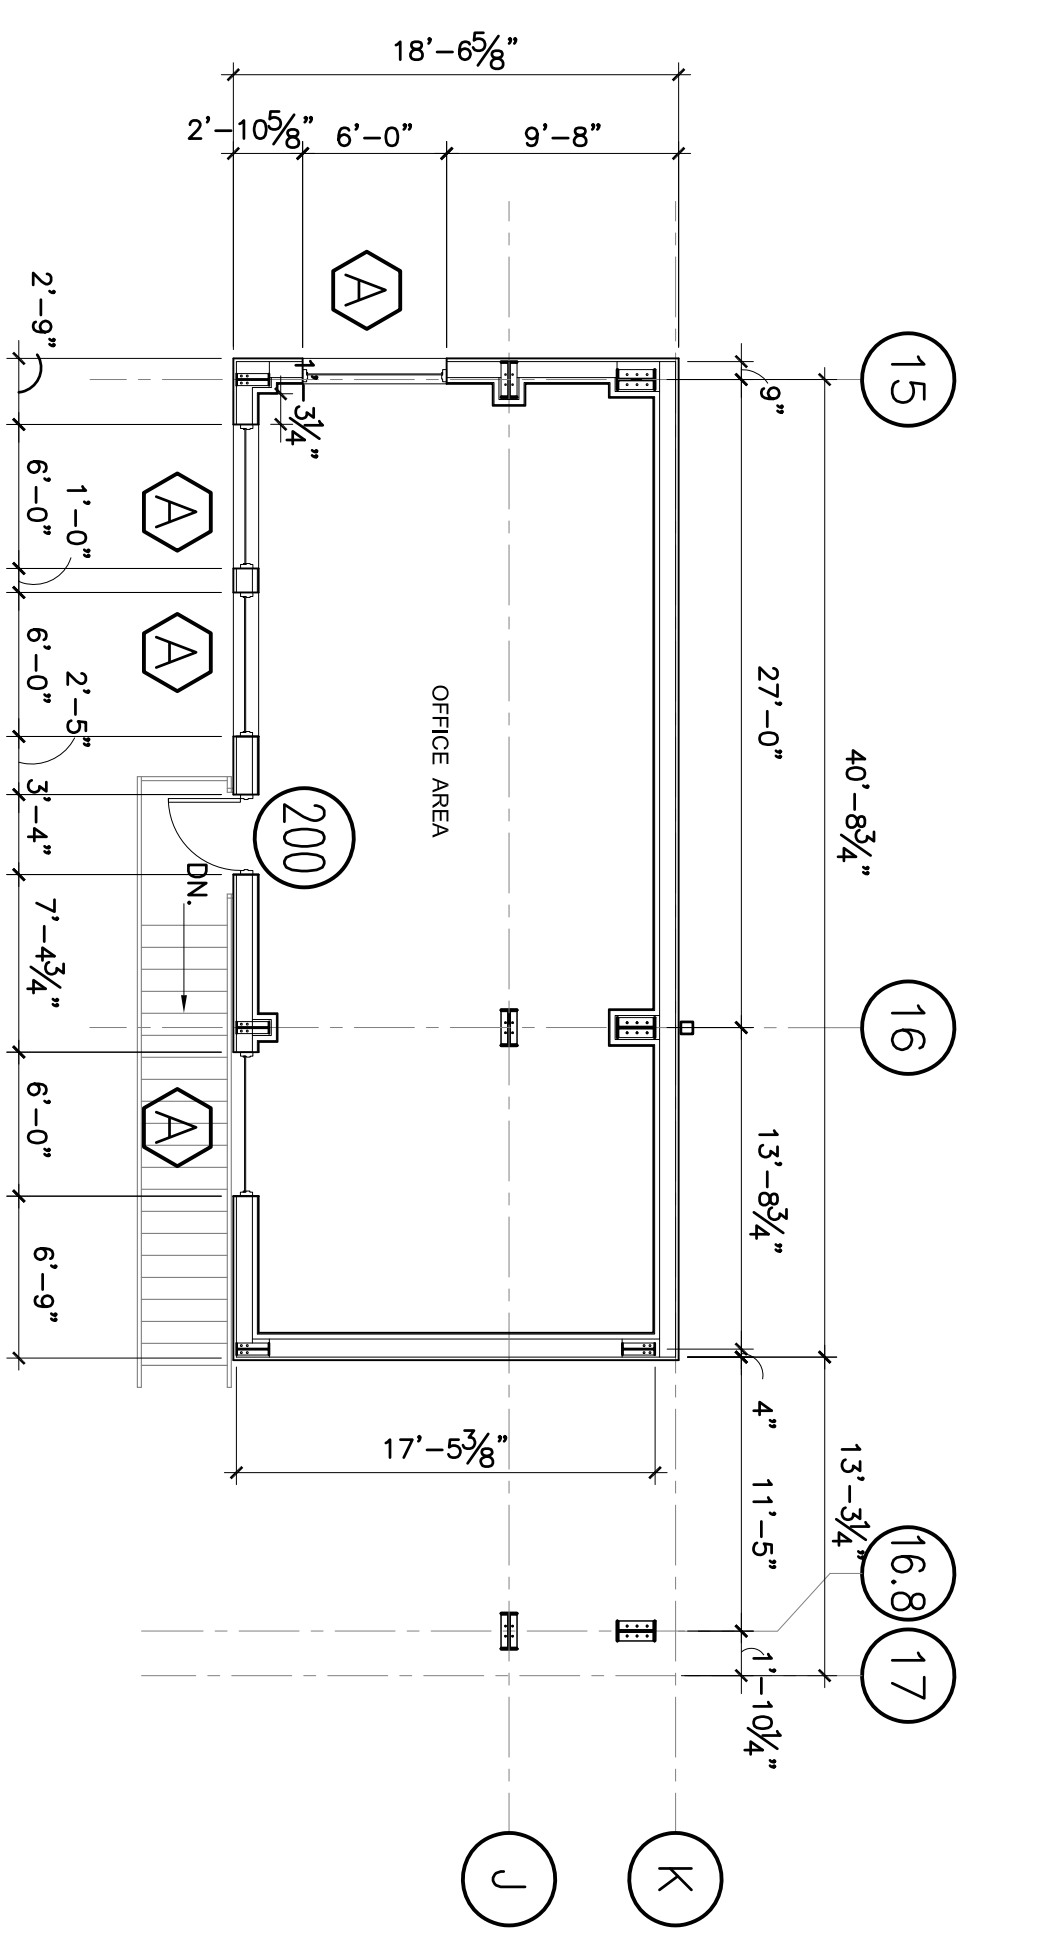

3 SECOND FLOOR PLAN - OFFICE

A1.0 SCALE: 1/8" = 1'-0"

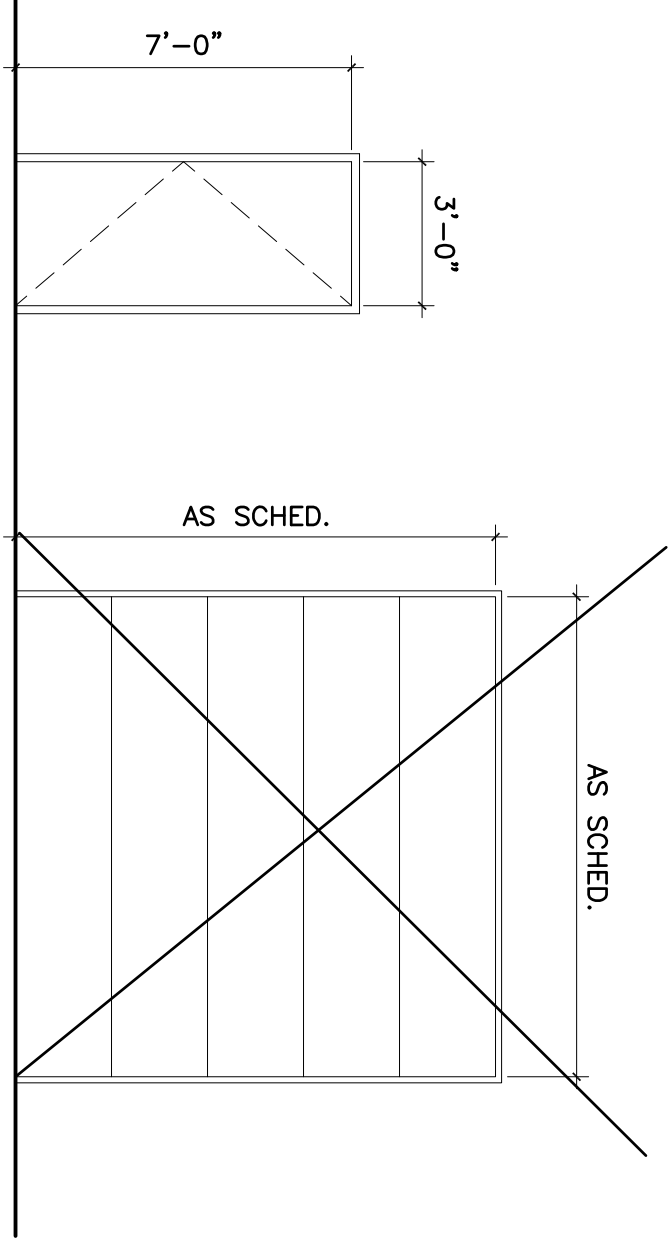

4 DOOR TYPES

A1.0 SCALE: 1/4" = 1'-0"

DOOR NO.	DOOR SCHEDULE	DOOR NO.	DOOR SCHEDULE
100	3'-0" x 7'-0" A H.M.	100	2, 3, 5
101	3'-0" x 7'-0" A H.M.	101	2, 3, 5
102	3'-0" x 7'-0" A H.M.	102	1, 2, 3, 4
200	3'-0" x 7'-0" A H.M.	200	1, 2, 3, 4

1. PROVIDE PANIC HARDWARE AND DOOR CLOSER.
2. FLOOR LANDING ON EACH SIDE OF DOOR SHALL BE AT THE SAME ELEVATION. VARIATION IN ELEVATION DUE TO DIFFERENCES IN MATERIAL FINISHES, SHALL BE LESS THAN OR EQUAL TO 1/2".
3. EXTERIOR LANDINGS ARE PERMITTED TO SLOPE AWAY FROM THE BUILDING AT NO MORE THAN 1/4" PER FT.
4. FULLY WELDED HOLLOW METAL FRAME WITH FIXED THROAT TO ACCOMMODATE THE WALL THICKNESS.
5. WITH PUSH/PULL HARDWARE AND DOOR CLOSERS W/ 5 LBS MAX. OPENING FORCE
6. 1 HR FIRE RATED DOOR

NEW ASSEMBLY CANOPY / BUILDING FOR NEO-RIG
 100 N. FM 3083 RD. E
 CONROE, TX. 77303

These drawings and accompanying specifications are an instrument of service and shall not be used for any other project without the written consent of KDW. All design and fabrication herein are the property of KDW and shall remain the property of KDW. No part of these drawings or specifications shall be reproduced or transmitted in any form or by any means, electronic, mechanical, photocopying, recording, or by any information storage and retrieval system, without the prior written consent of KDW.

A1.0
 FLOOR PLANS

PROJECT NO. 16-791
 DRAWING DATE: Jun 26, 2018

ISSUE DATE 09-21-17
 REVISIONS